


-----	LEGEND
⊗	Lot Connection (Riser)

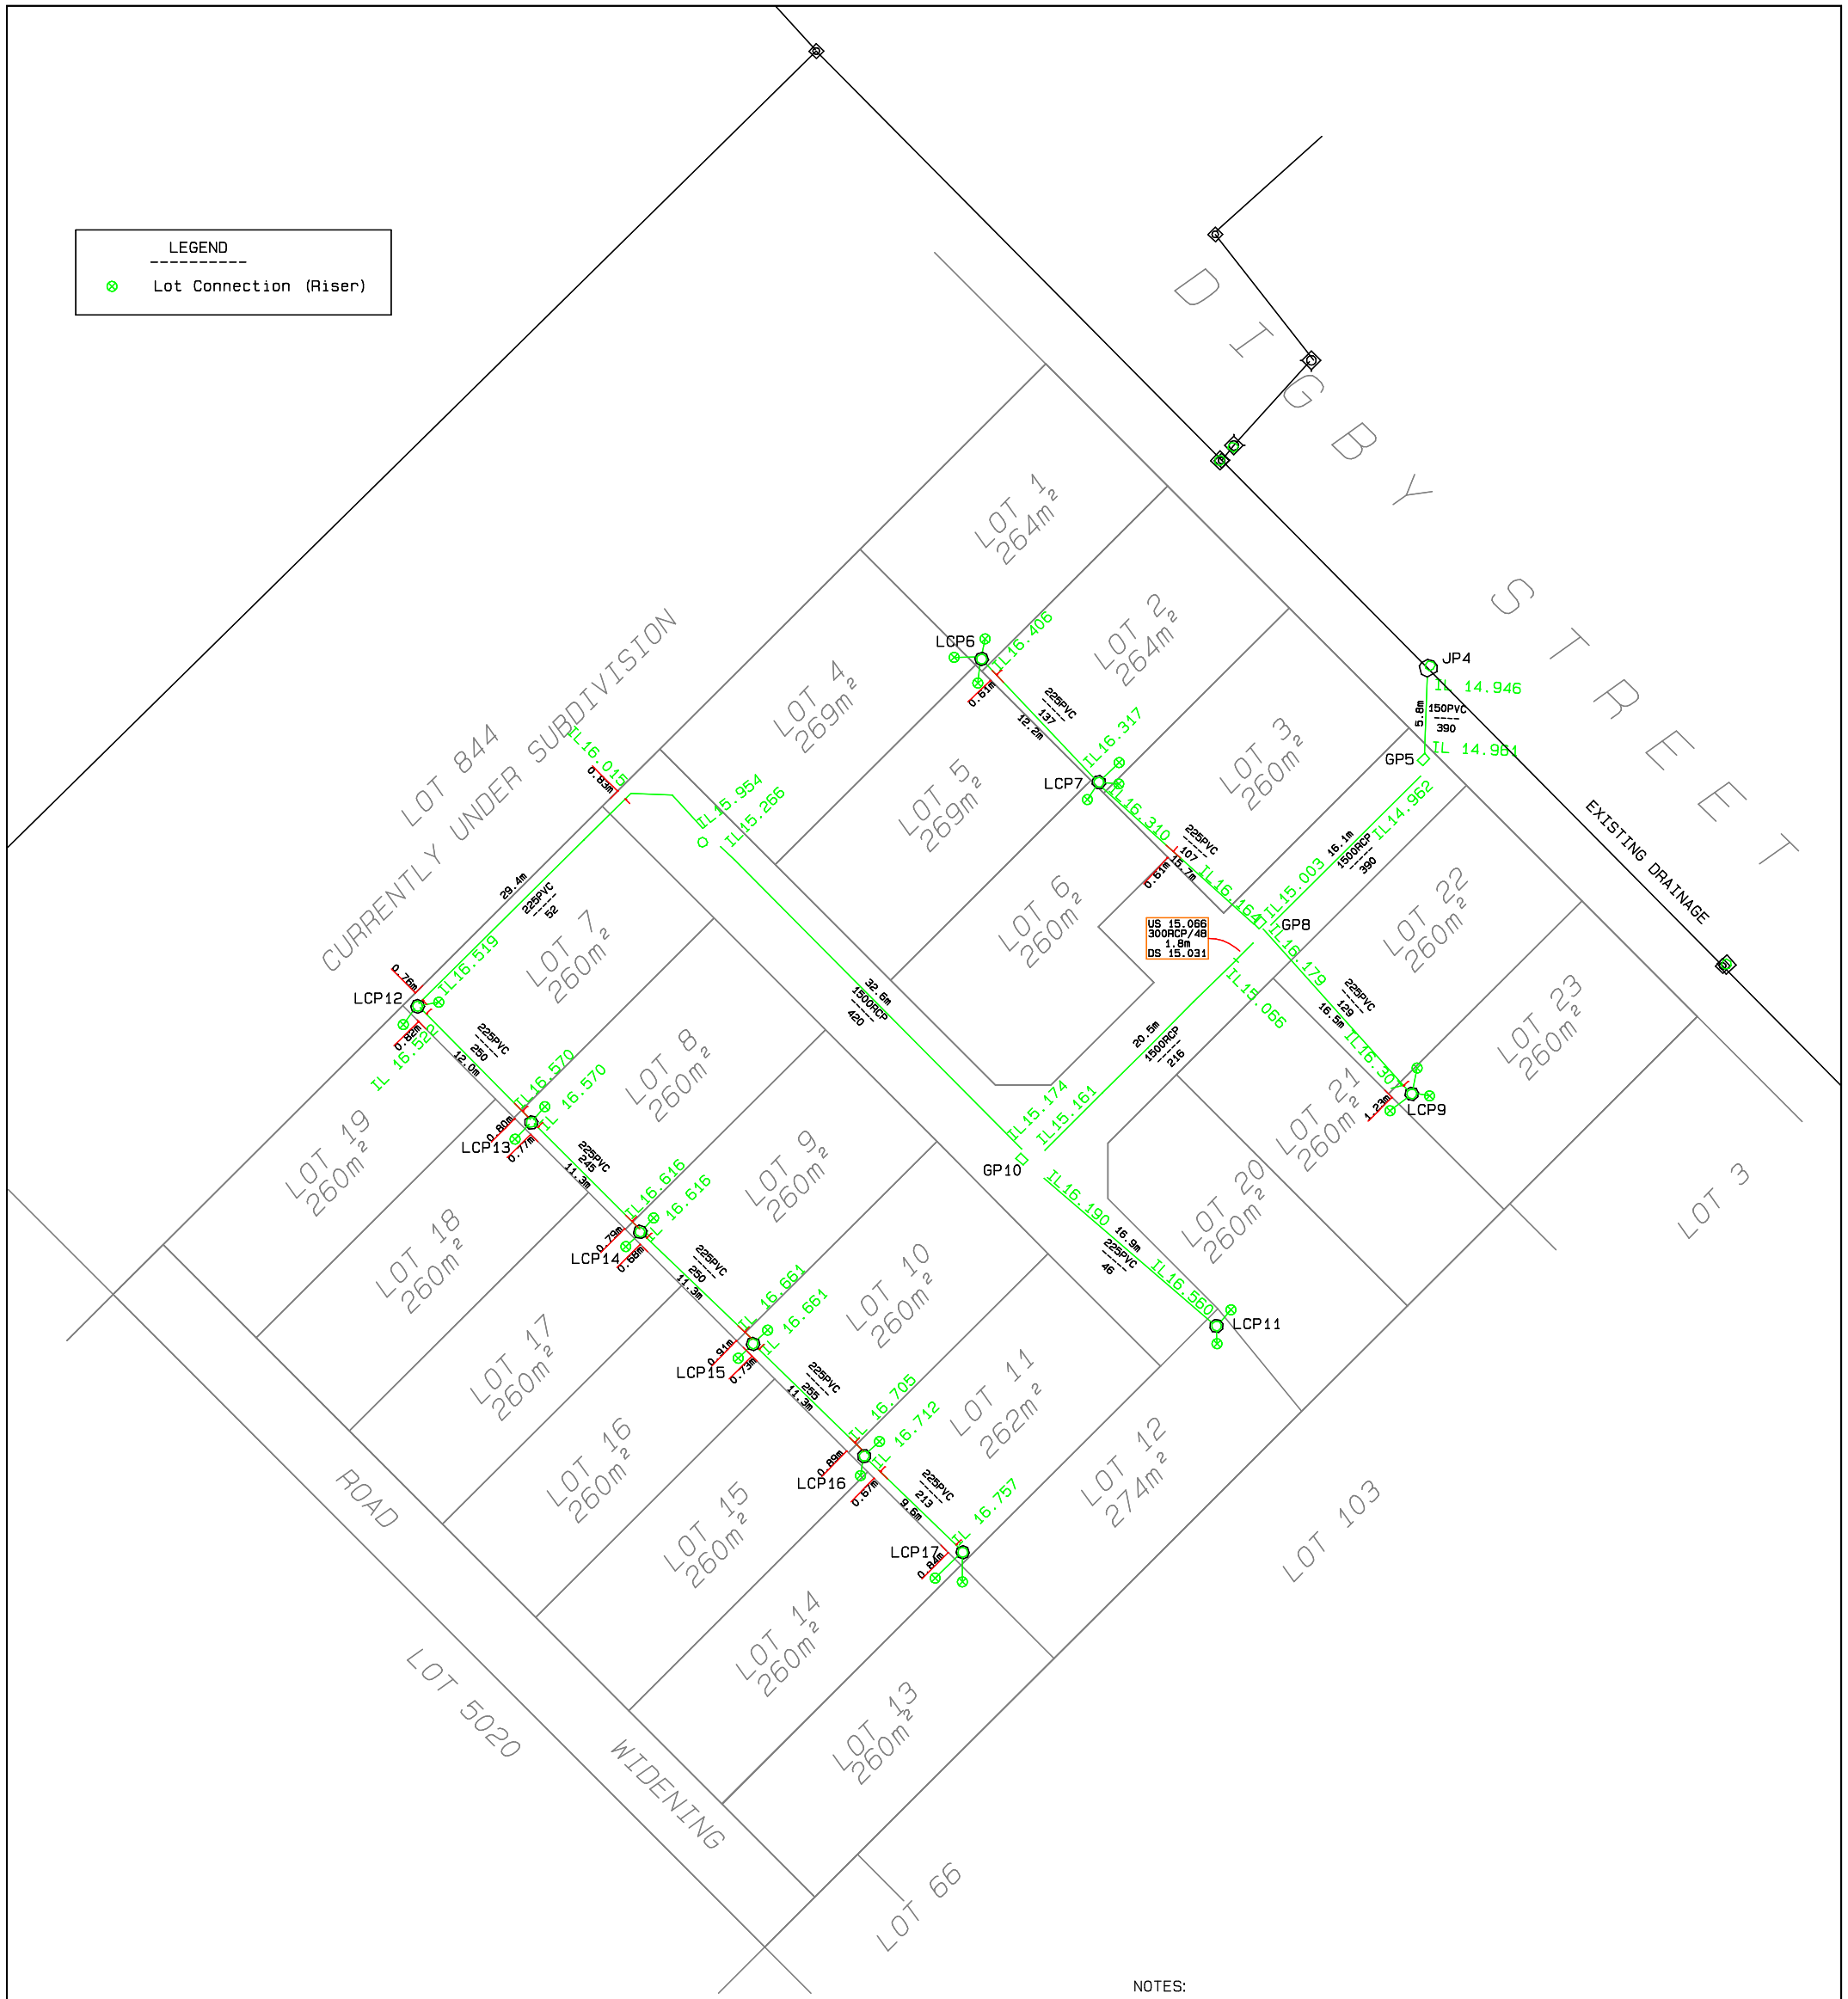

NOTES:

VERTICAL DATUM IS APPROXIMATE AHD ONLY AND HEIGHTS HAVE BEEN ADOPTED FROM ORACLE 9005 WITH A SUPPLIED VALUE OF 17.262m

IT SHOULD BE NOTED THAT ADDITIONAL UNDERGROUND SERVICES DID NOT FORM PART OF THIS SURVEY, THEREFORE PRIOR TO ANY DEMOLITION, EXCAVATION, OR CONSTRUCTION, THE RELEVANT AUTHORITY SHOULD BE CONTACTED, AND THE CERTIFICATE OF TITLE CHECKED FOR EASEMENTS AND ENCUMBRANCES

SURVEY CARRIED OUT USING TOTAL STATION, POSITIONS AND HEIGHTS ARE ACCURATE TO +/- 10MM

BOUNDARY SHOWN IS AS SUPPLIED BY CLIENT

This drawing is and shall remain the property of BOS Surveying PTY LTD, trading as Survey Results. Unauthorised use or copying in whole or part without the permission of BOS Surveying PTY LTD trading as Survey Results constitutes a copyright infringement.

Rev	Description	Date	CHK
3	Minor IL Adjustments	23/01/17	KM
2	Minor IL Adjustments	18/01/17	KM
1	Amend Annotations	16/01/17	KM
0	Initial Issue	22/12/16	KM

SURVEY RESULTS

Head Office
6/516 Guildford Road
Bayswater WA 6053
PO Box 384, Bayswater WA 6933
admin@surveyresults.com.au
www.surveyresults.com.au

PI (08) 9379 2001
FI (08) 9379 2003

CHK	Initials	KM	Date	23/01/17	Approved	General manager B O'Sullivan
Drawn	A. White		Job Ref			
Date	23/01/2017		S:_SR1012-34_Wormally Civil_Lot 843 Digby St Gosnells\Digital Files\ 170123 Drainage Asccon AK.pro			
Hor Datum	PCG		Surveyor: A. White			
Vert Datum	AHD		Date of Capture: Various			
Scale	1: 500@A3		Drawing No			
Client	Wormally		SR1012-34-020			

Project Name
Wormally Lot 843
Digby Street Gosnells

Drawing Title
Internal Drainage As Constructed

Client
Wormally

Drawing No
SR1012-34-020