


LEGEND

 ○ FP Flushing Point
 X SV Sluice Valve

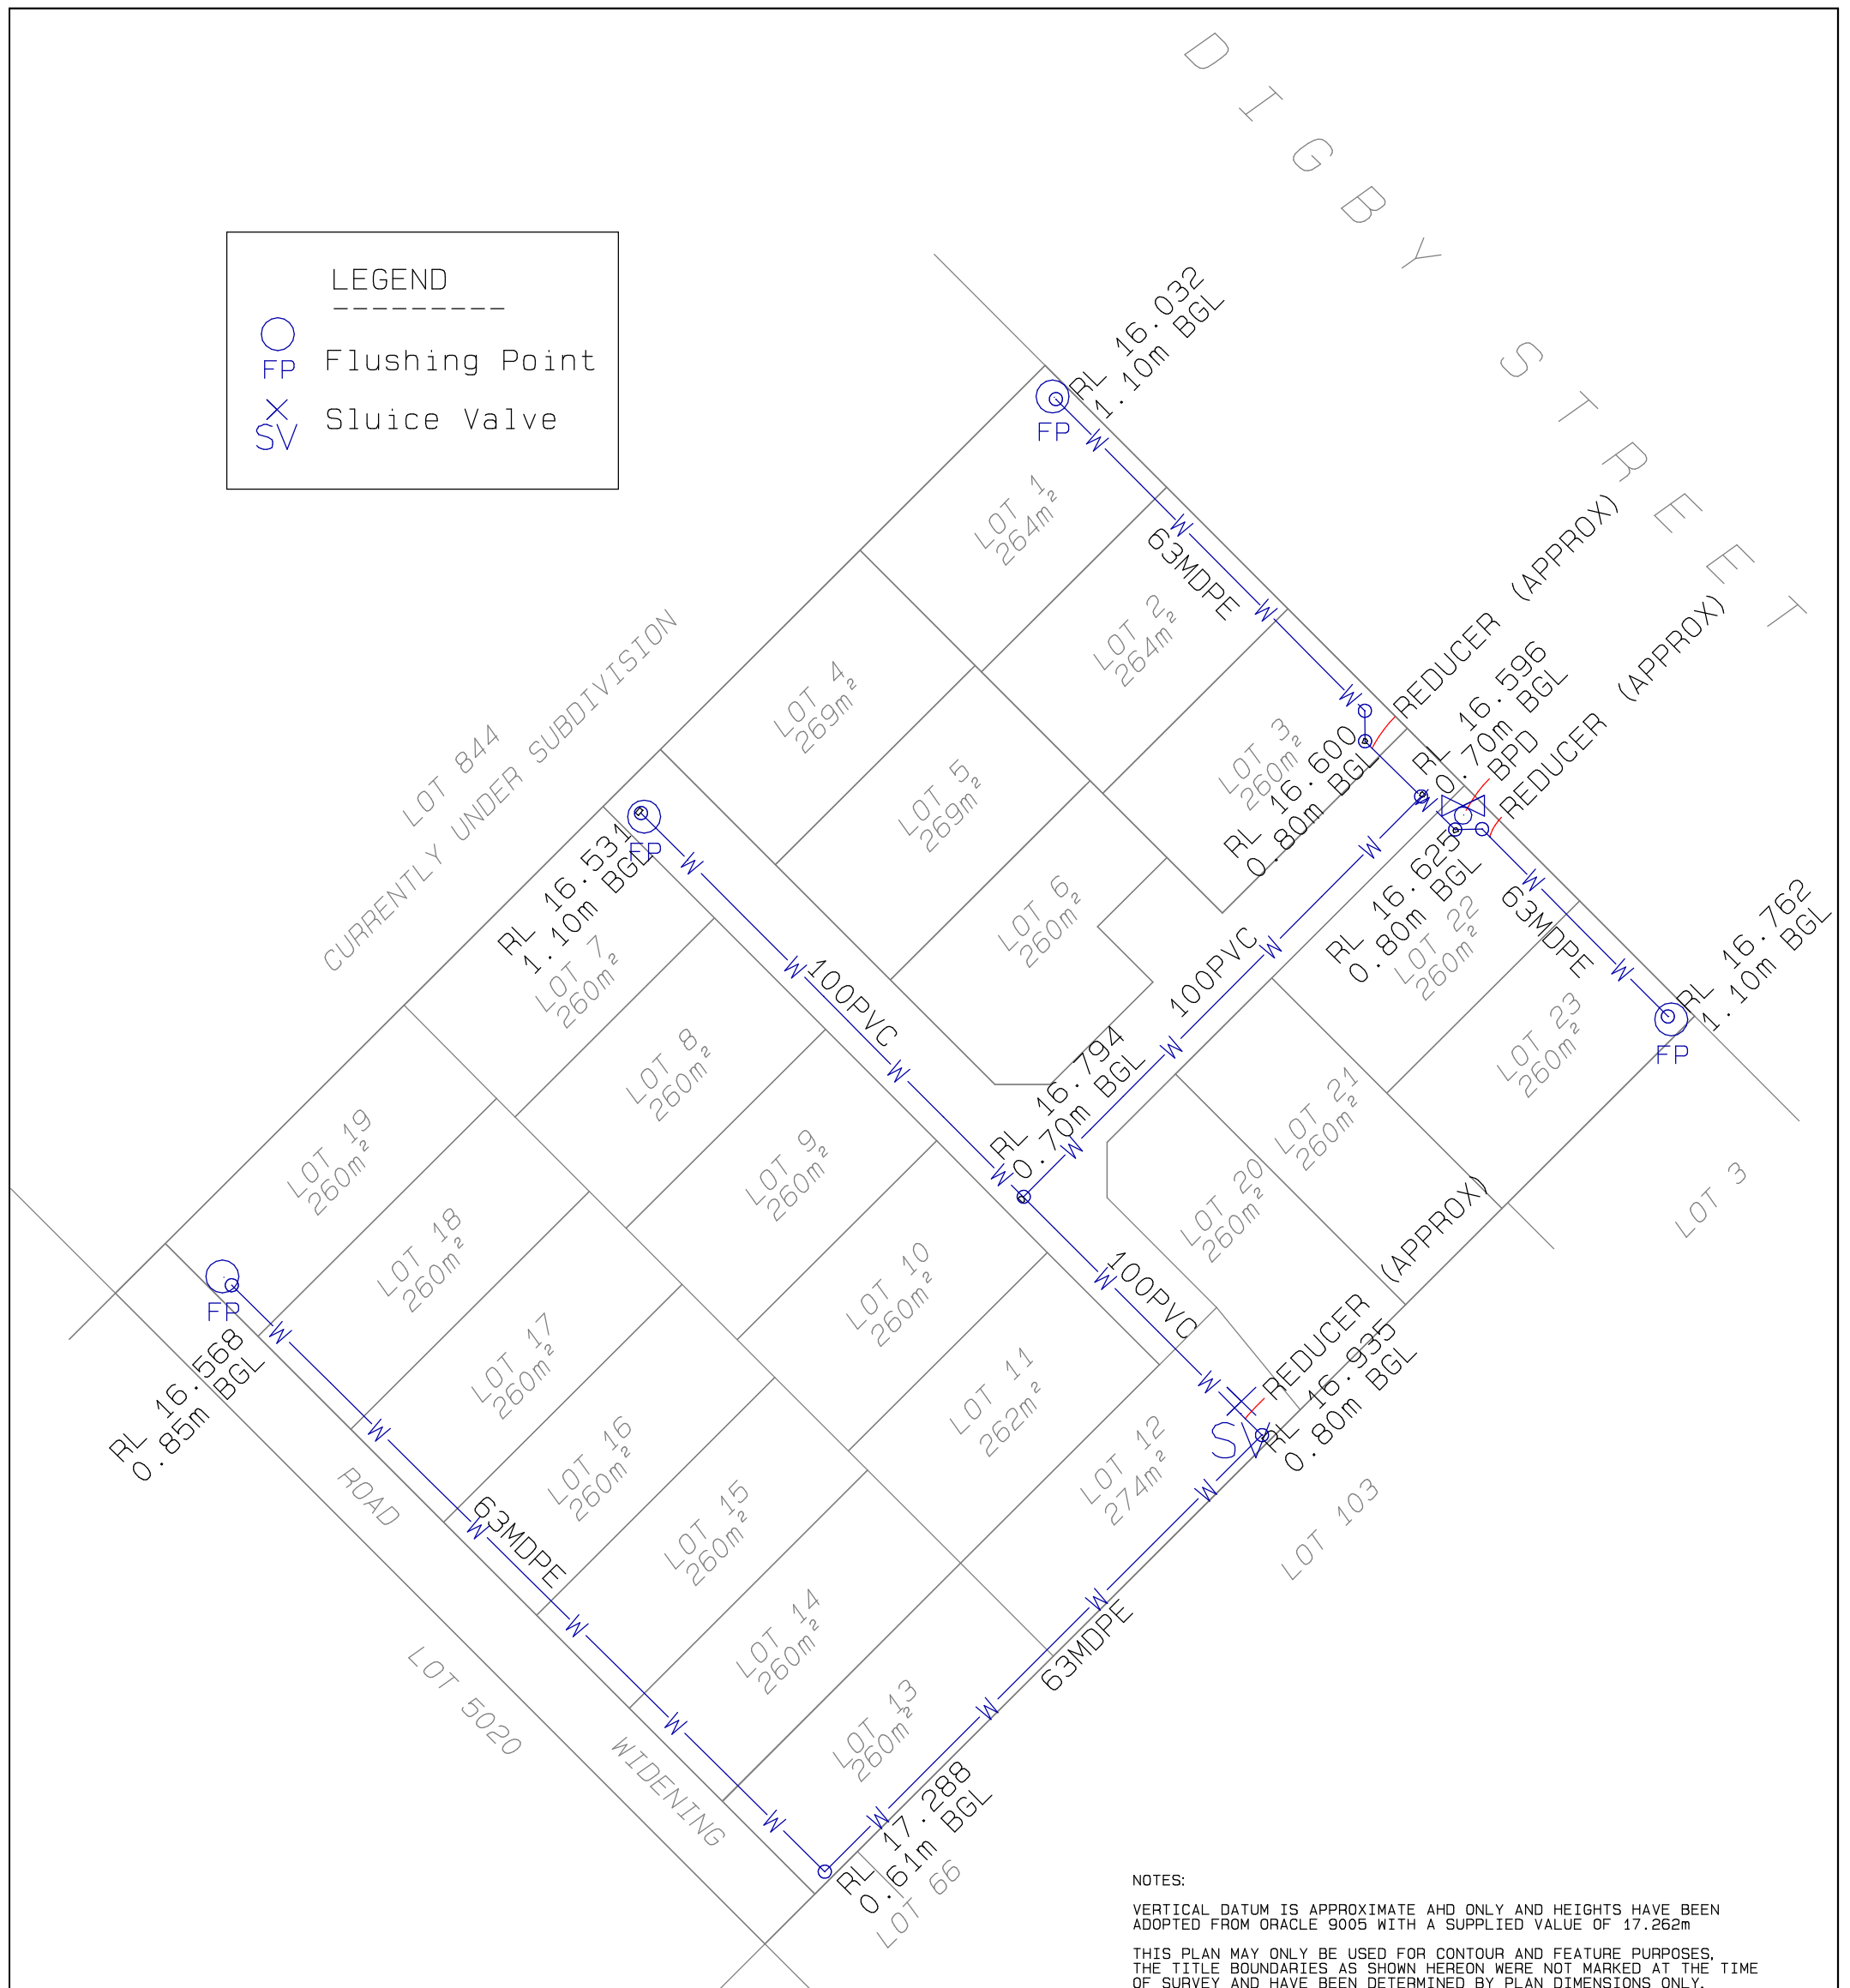

NOTES:

VERTICAL DATUM IS APPROXIMATE AHD ONLY AND HEIGHTS HAVE BEEN ADOPTED FROM ORACLE 9005 WITH A SUPPLIED VALUE OF 17.262m

THIS PLAN MAY ONLY BE USED FOR CONTOUR AND FEATURE PURPOSES. THE TITLE BOUNDARIES AS SHOWN HEREON WERE NOT MARKED AT THE TIME OF SURVEY AND HAVE BEEN DETERMINED BY PLAN DIMENSIONS ONLY, POSITIONED OVER EVIDENCE OF OCCUPATION

IT SHOULD BE NOTED THAT ADDITIONAL UNDERGROUND SERVICES DID NOT FORM PART OF THIS SURVEY. THEREFORE PRIOR TO ANY DEMOLITION, EXCAVATION, OR CONSTRUCTION, THE RELEVANT AUTHORITY SHOULD BE CONTACTED, AND THE CERTIFICATE OF TITLE CHECKED FOR EASEMENTS AND ENCUMBRANCES

SURVEY CARRIED OUT USING RTK GPS. POSITIONS AND HEIGHTS ARE ACCURATE TO +/- 30MM

BOUNDARY SHOWN IS AS SUPPLIED BY CLIENT

ALL RL's SHOWN ARE TOP OF PIPE

This drawing is and shall remain the property of BOS Surveying PTY LTD, trading as Survey Results. Unauthorised use or copying in whole or part without the permission of BOS Surveying PTY LTD trading as Survey Results constitutes a copyright infringement.

Rev	Description	Date	CHK
1	Re-survey Lot 13 bend	16/01/17	KM
0	Initial Issue	22/12/16	KM

Project Name
 Normall Lot 843
 Digby Street Gosnells

SURVEY RESULTS

Head Office
 6/516 Guildford Road
 Bayswater WA 6053
 PO Box 384, Bayswater WA 6933

PI (08) 9379 2001
 FI (08) 9379 2003
 admin@surveyresults.com.au
 www.surveyresults.com.au

Drawing Title
 Water As Constructed

CHK	Initials	Date	16/01/17
Drawn	A. White		
Date	16/01/2017		
Hor Datum	PCG		
Vert Datum	AHD		
Scale	1: 500@A3		
Client	Wormall CIVIL		

Approved	General manager B O'Sullivan
Job Ref	S\..SR1012-34_Wormall Civil_Lot 843 Digby St Gosnells\Digital Files\ 170116 Services Asccon AK.pro
Surveyor:	A. White
Date of Capture:	Various
Drawing No	SR1012-34-015