


| LEGEND | |
|--------|----------------------------|
| | Lot Connection (Riser) |
| | Sewer CO (at ground level) |
| | Distance to downstream CO |
| | Distance square off line |
| | Distance IL to Top Riser |

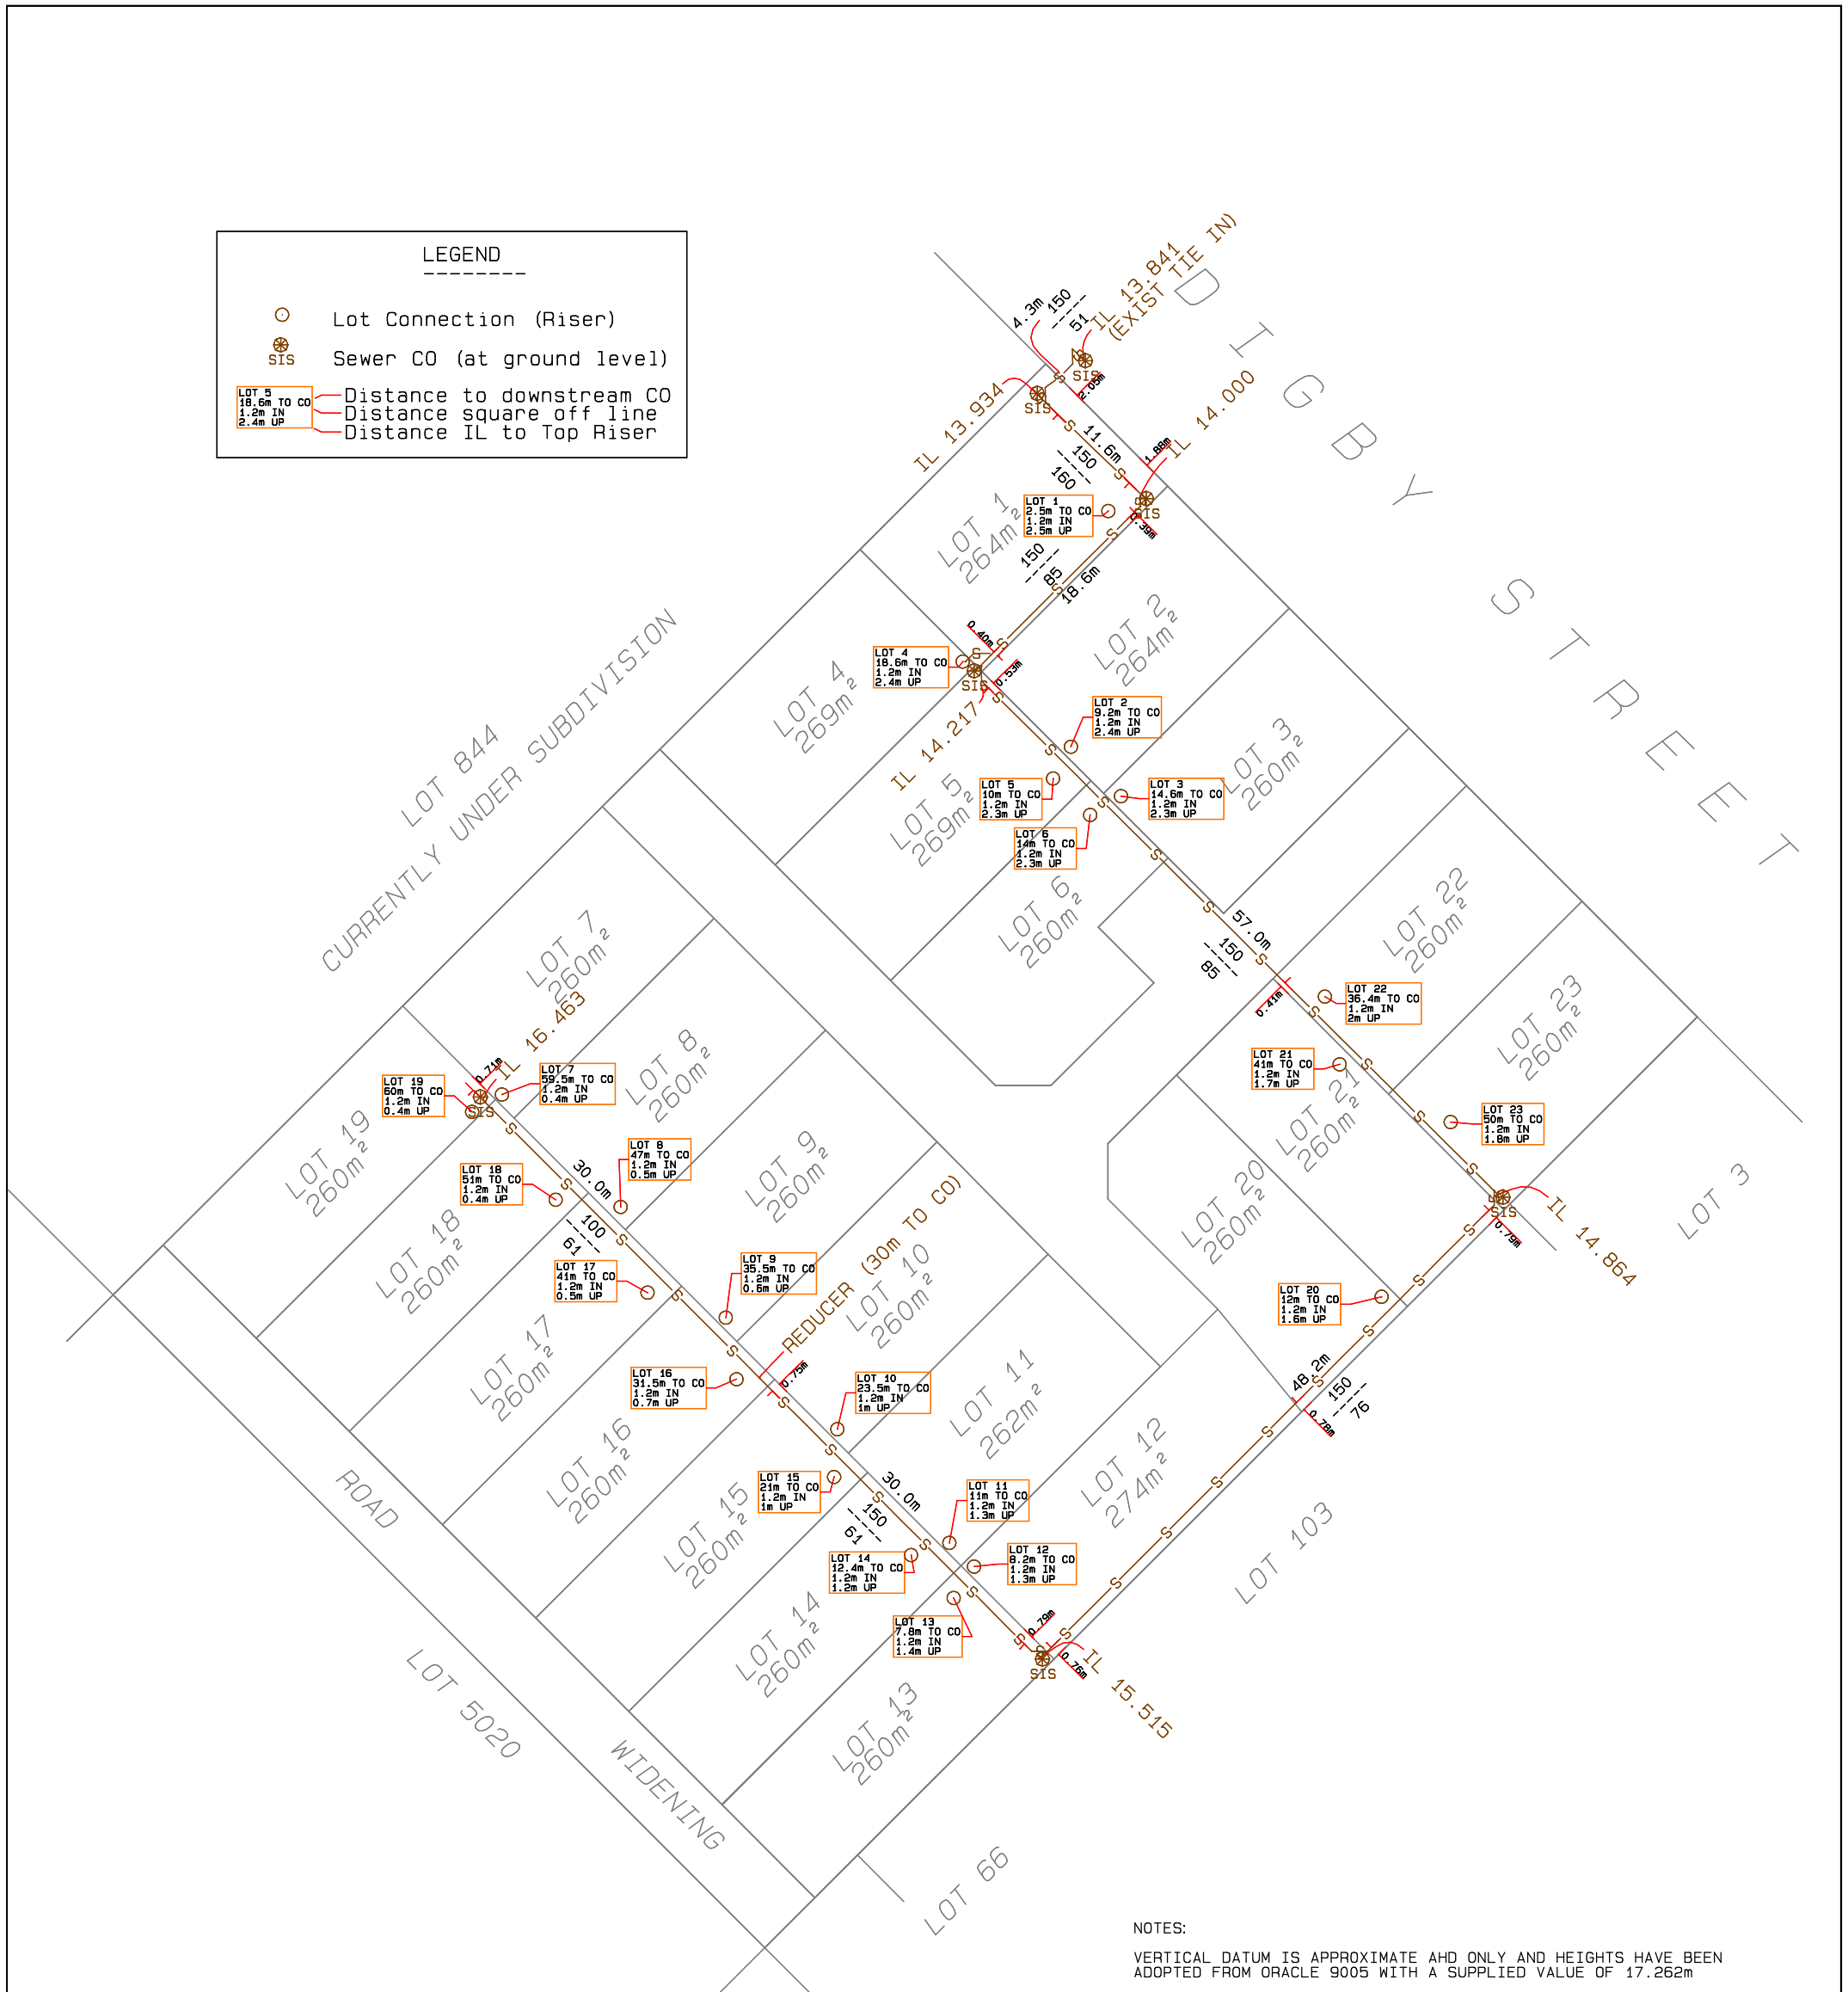

NOTES:

VERTICAL DATUM IS APPROXIMATE AHD ONLY AND HEIGHTS HAVE BEEN ADOPTED FROM ORACLE 9005 WITH A SUPPLIED VALUE OF 17.262m

THIS PLAN MAY ONLY BE USED FOR CONTOUR AND FEATURE PURPOSES, THE TITLE BOUNDARIES AS SHOWN HEREON WERE NOT MARKED AT THE TIME OF SURVEY

IT SHOULD BE NOTED THAT ADDITIONAL UNDERGROUND SERVICES DID NOT FORM PART OF THIS SURVEY, THEREFORE PRIOR TO ANY DEMOLITION, EXCAVATION, OR CONSTRUCTION, THE RELEVANT AUTHORITY SHOULD BE CONTACTED, AND THE CERTIFICATE OF TITLE CHECKED FOR EASEMENTS AND ENCUMBRANCES

SURVEY CARRIED OUT USING TOTAL STATION, POSITIONS AND HEIGHTS ARE ACCURATE TO +/-10MM

BOUNDARY SHOWN IS AS SUPPLIED BY CLIENT


This drawing is and shall remain the property of BOS Surveying PTY LTD, trading as Survey Results. Unauthorised use or copying in whole or part without the permission of BOS Surveying PTY LTD trading as Survey Results constitutes a copyright infringement.

| Rev | Description | Date | CHK |
|-----|--------------------------|----------|-----|
| 2 | Include Junction offsets | 20/01/17 | JOS |
| 1 | Update Annotations | 16/01/17 | KM |
| 0 | Initial Issue | 22/12/16 | KM |

SURVEY RESULTS

Head Office
6/516 Guildford Road
Bayswater WA 6053
PO Box 384, Bayswater WA 6933

PI (08) 9379 2001
FI (08) 9379 2003
admin@surveyresults.com.au
www.surveyresults.com.au

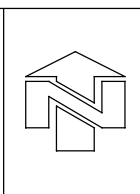

| CHK | Initials | KM | Date | 20/01/17 | Approved | General manager B O'Sullivan |
|------------|-----------------------|----|------|----------|------------------|---|
| Drawn | A. White | | | | Job Ref | |
| Date | 20/01/2017 | | | | | S:_SR1012-34_Wormally Civil_Lot 843 Digby St Gosnells\Digital Files\ 170120 Sewer Ascon AW.pro |
| Hor Datum | PCG | | | | Surveyor: | A. White |
| Vert Datum | AHD | | | | Date of Capture: | Various |
| Scale | 1: 500@A3 | | | | Drawing No | SR1012-34-019 |
| Client | Wormally CIVIL | | | | | |

Project Name
Wormally Lot 843
Digby Street Gosnells

Drawing Title
Sewer As Constructed