


Positive differences indicate the lot level is above design
Negative differences indicate the lot level is below design

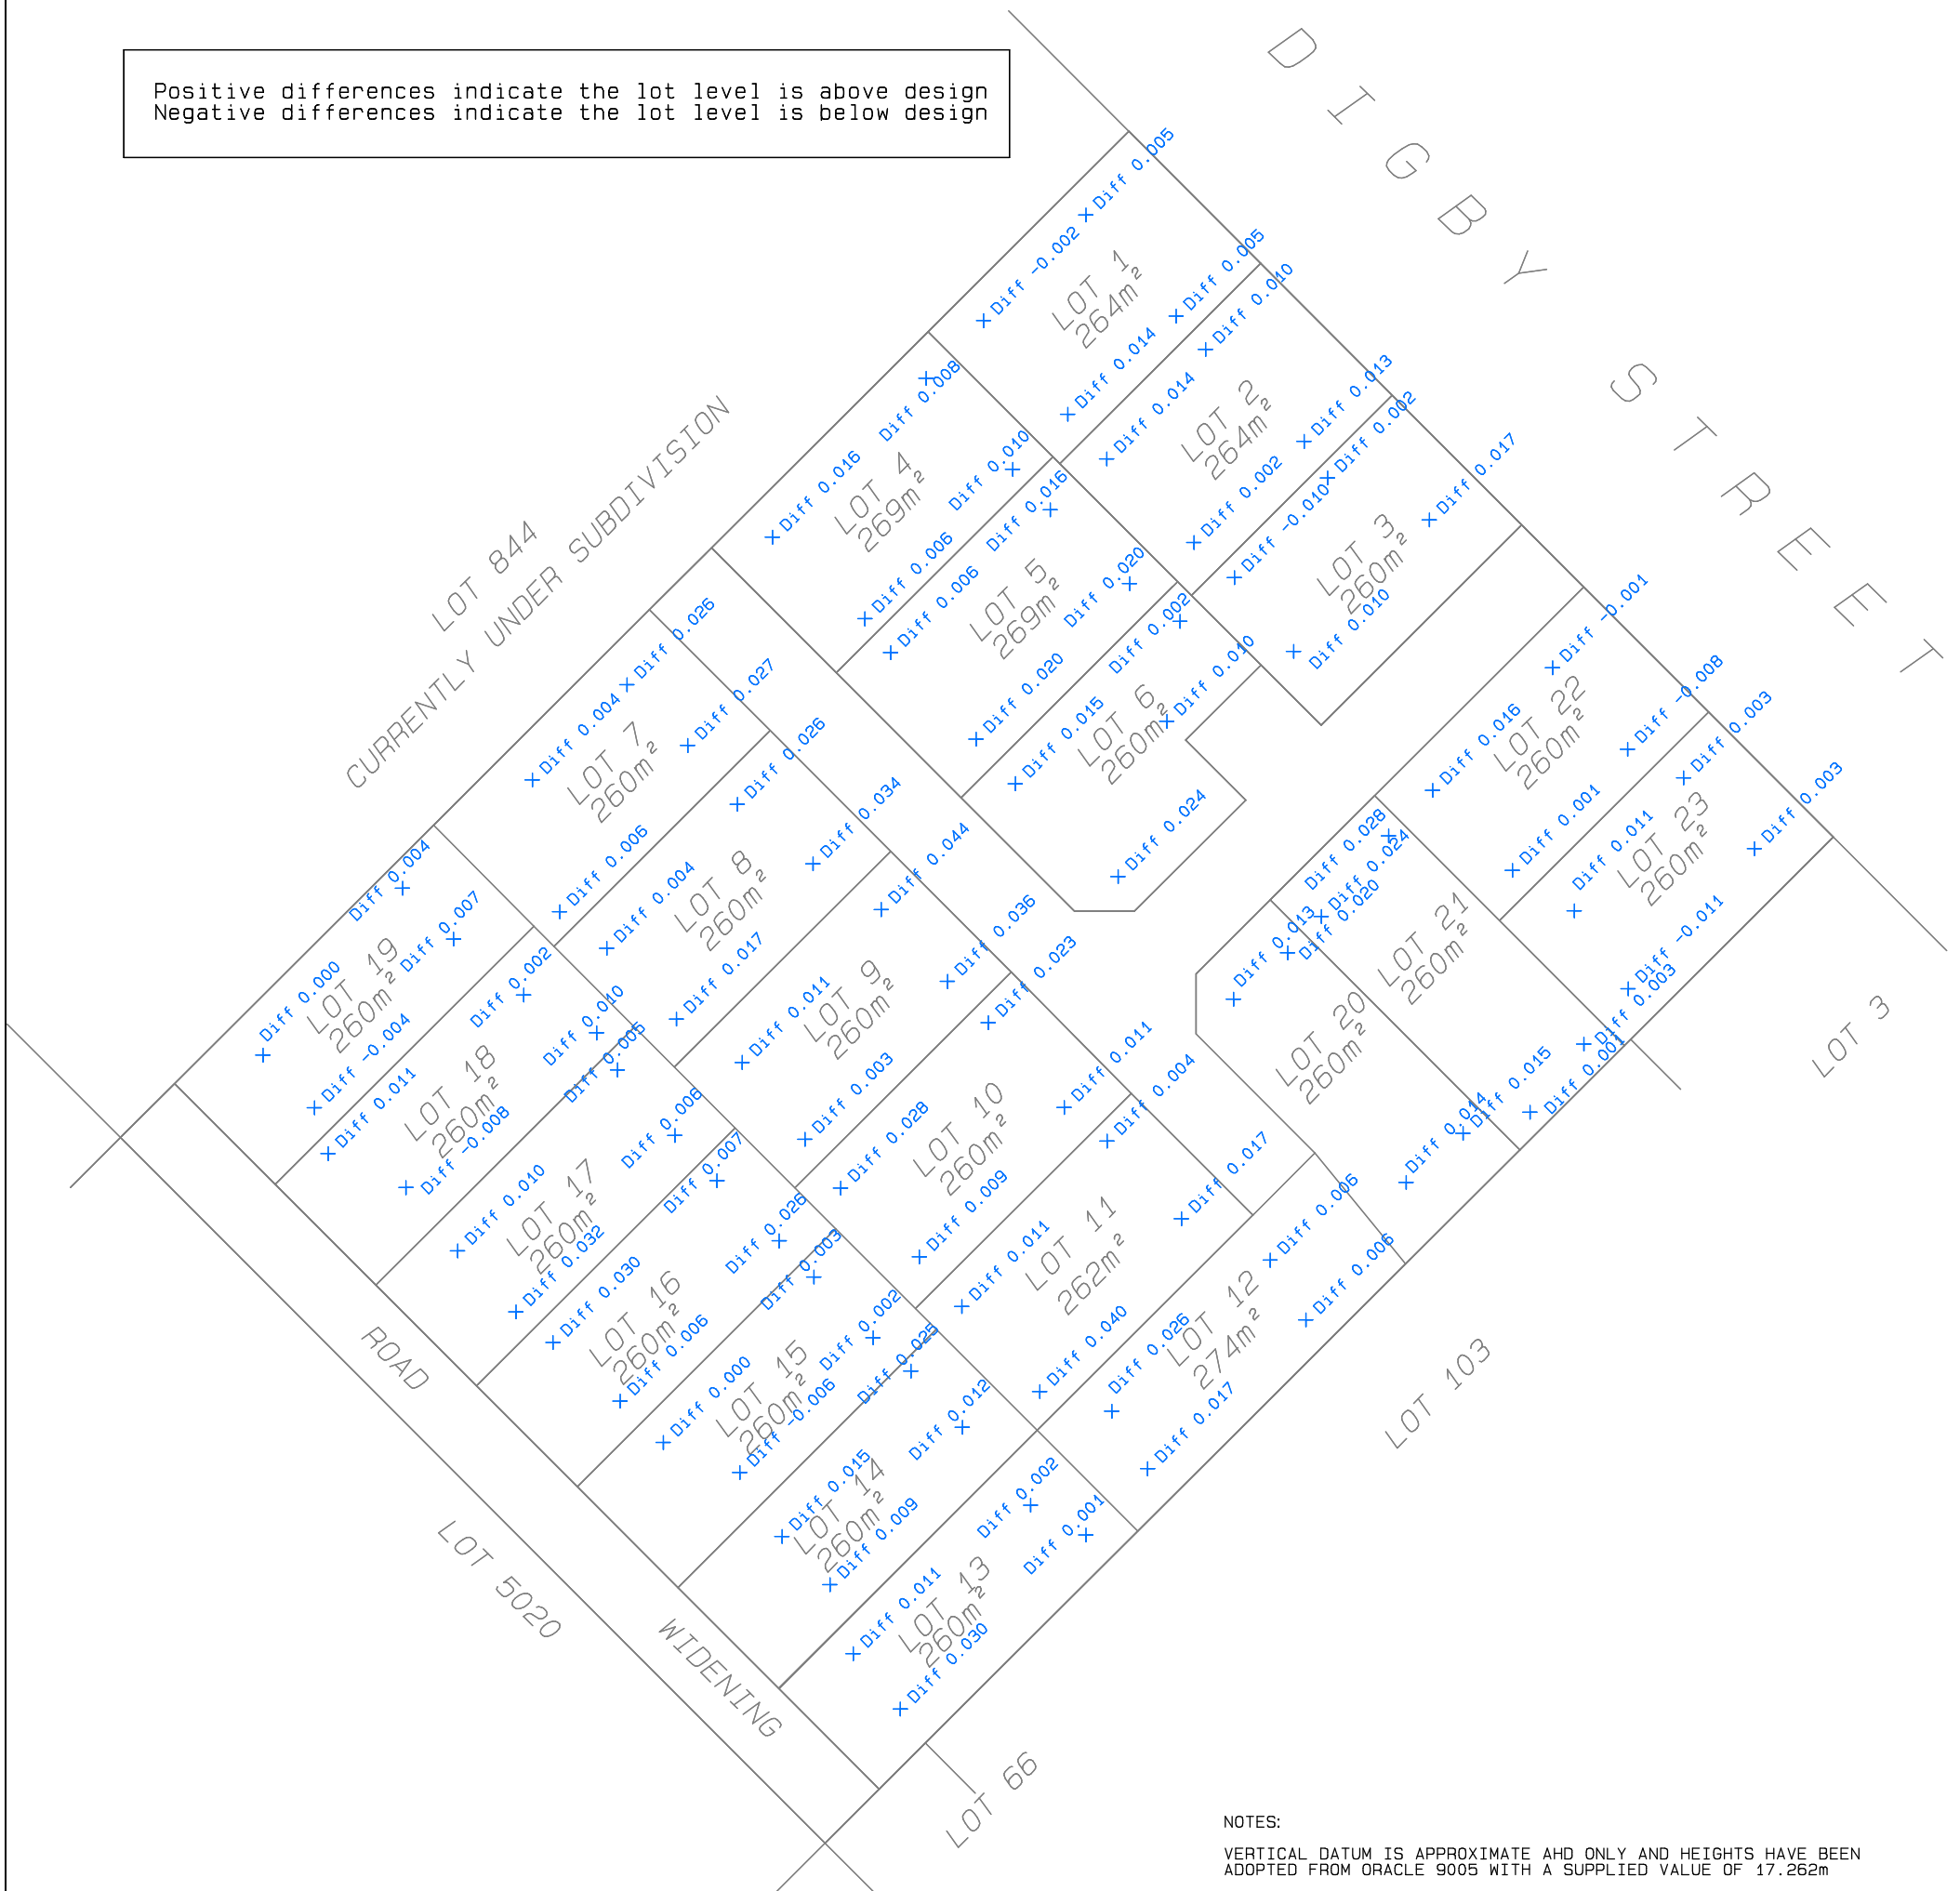

NOTES:
VERTICAL DATUM IS APPROXIMATE AHD ONLY AND HEIGHTS HAVE BEEN ADOPTED FROM ORACLE 9005 WITH A SUPPLIED VALUE OF 17.262m
THIS PLAN MAY ONLY BE USED FOR CONTOUR AND FEATURE PURPOSES, THE TITLE BOUNDARIES AS SHOWN HEREON WERE NOT MARKED AT THE TIME OF SURVEY
IT SHOULD BE NOTED THAT UNDERGROUND SERVICES DID NOT FORM PART OF THIS SURVEY, THEREFORE PRIOR TO ANY DEMOLITION, EXCAVATION, OR CONSTRUCTION, THE RELEVANT AUTHORITY SHOULD BE CONTACTED, AND THE CERTIFICATE OF TITLE CHECKED FOR EASEMENTS AND ENCUMBRANCES
SURVEY CARRIED OUT USING TOTAL STATION, POSITIONS AND HEIGHTS ARE ACCURATE TO +/-10MM
BOUNDARY SHOWN IS AS SUPPLIED BY CLIENT

This drawing is and shall remain the property of BOS Surveying PTY LTD, trading as Survey Results. Unauthorised use or copying in whole or part without the permission of BOS Surveying PTY LTD trading as Survey Results constitutes a copyright infringement.

				<p>SURVEY RESULTS</p> <p>Head Office 6/516 Guildford Road Bayswater WA 6053 admin@surveyresults.com.au www.surveyresults.com.au</p> <p>PI (08) 9379 2001 FI (08) 9379 2003</p>	
0	Initial Issue	22/12/16	KM		
Rev	Description	Date	CHK		
Project Name Wormall Lot 843 Digby Street Gosnells					
Drawing Title Earthworks As Constructed					

CHK	Initials	KM	Date	22/12/16	Approved	General manager	B O'Sullivan
Drawn	A. White		Job Ref		S:_SR1012-34_Wormall Civil_Lot 843 Digby St Gosnell\Digital Files\ 161222 Earthworks Asccon AK.prc		
Date	22/12/2016		Surveyor:		A. White		
Hor Datum	PCG		Date of Capture:		21/12/2016		
Vert Datum	AHD		Drawing No		SR1012-34-017		
Scale	1: 500@A3		Client				